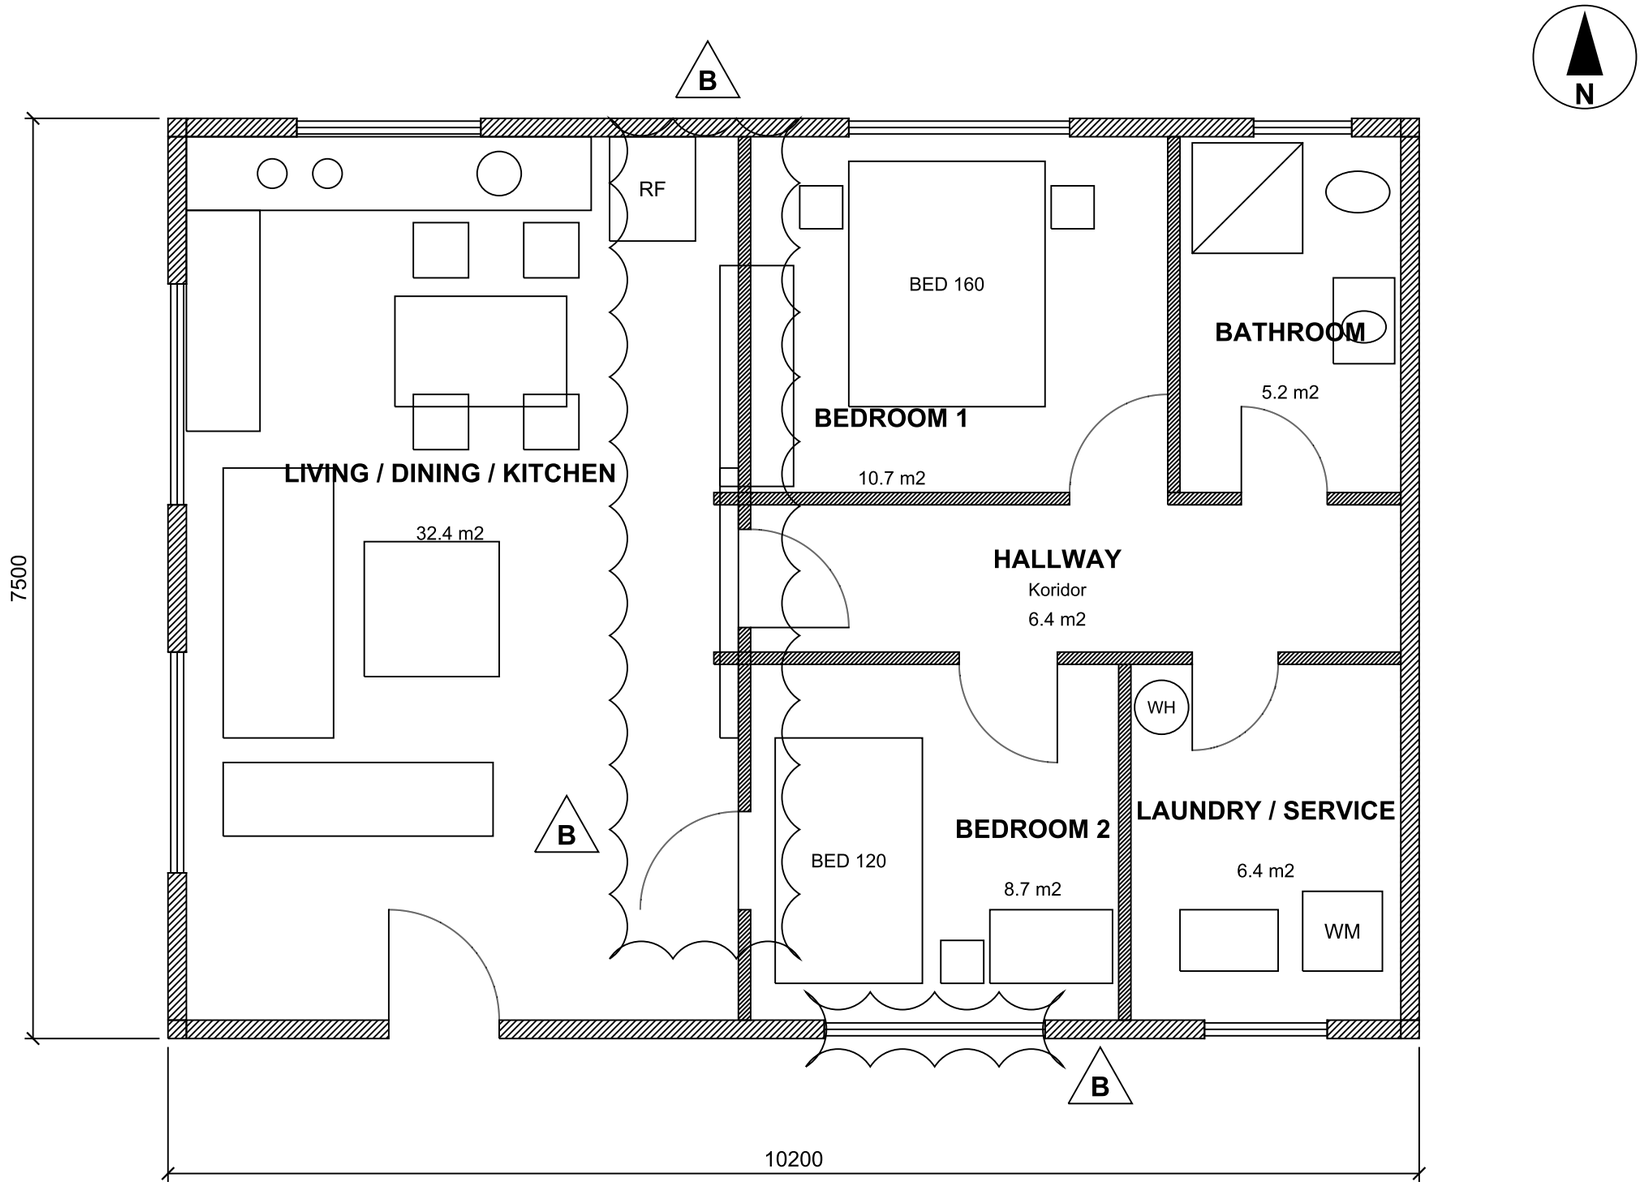


SCALE 1:50

0 1 2 3 4 5 m

WEBKHAL
Technical drawing - 3D
webkhal.dev


PROJECT
RESIDENTIAL UNIT - TYPE 70
DEMONSTRATION PROJECT - NOT FOR CONSTRUCTION
Portfolio sample - fictitious project

SHEET TITLE
FURNITURE LAYOUT PLAN

SCALE	1:50 @ A3
UNITS	mm
DRAWN	J. Khalfallah
DATE	26.10.2026

SHEET
A-101

REV			
B	26.10.26	Site redlines incorporated
A	26.10.26	First issue

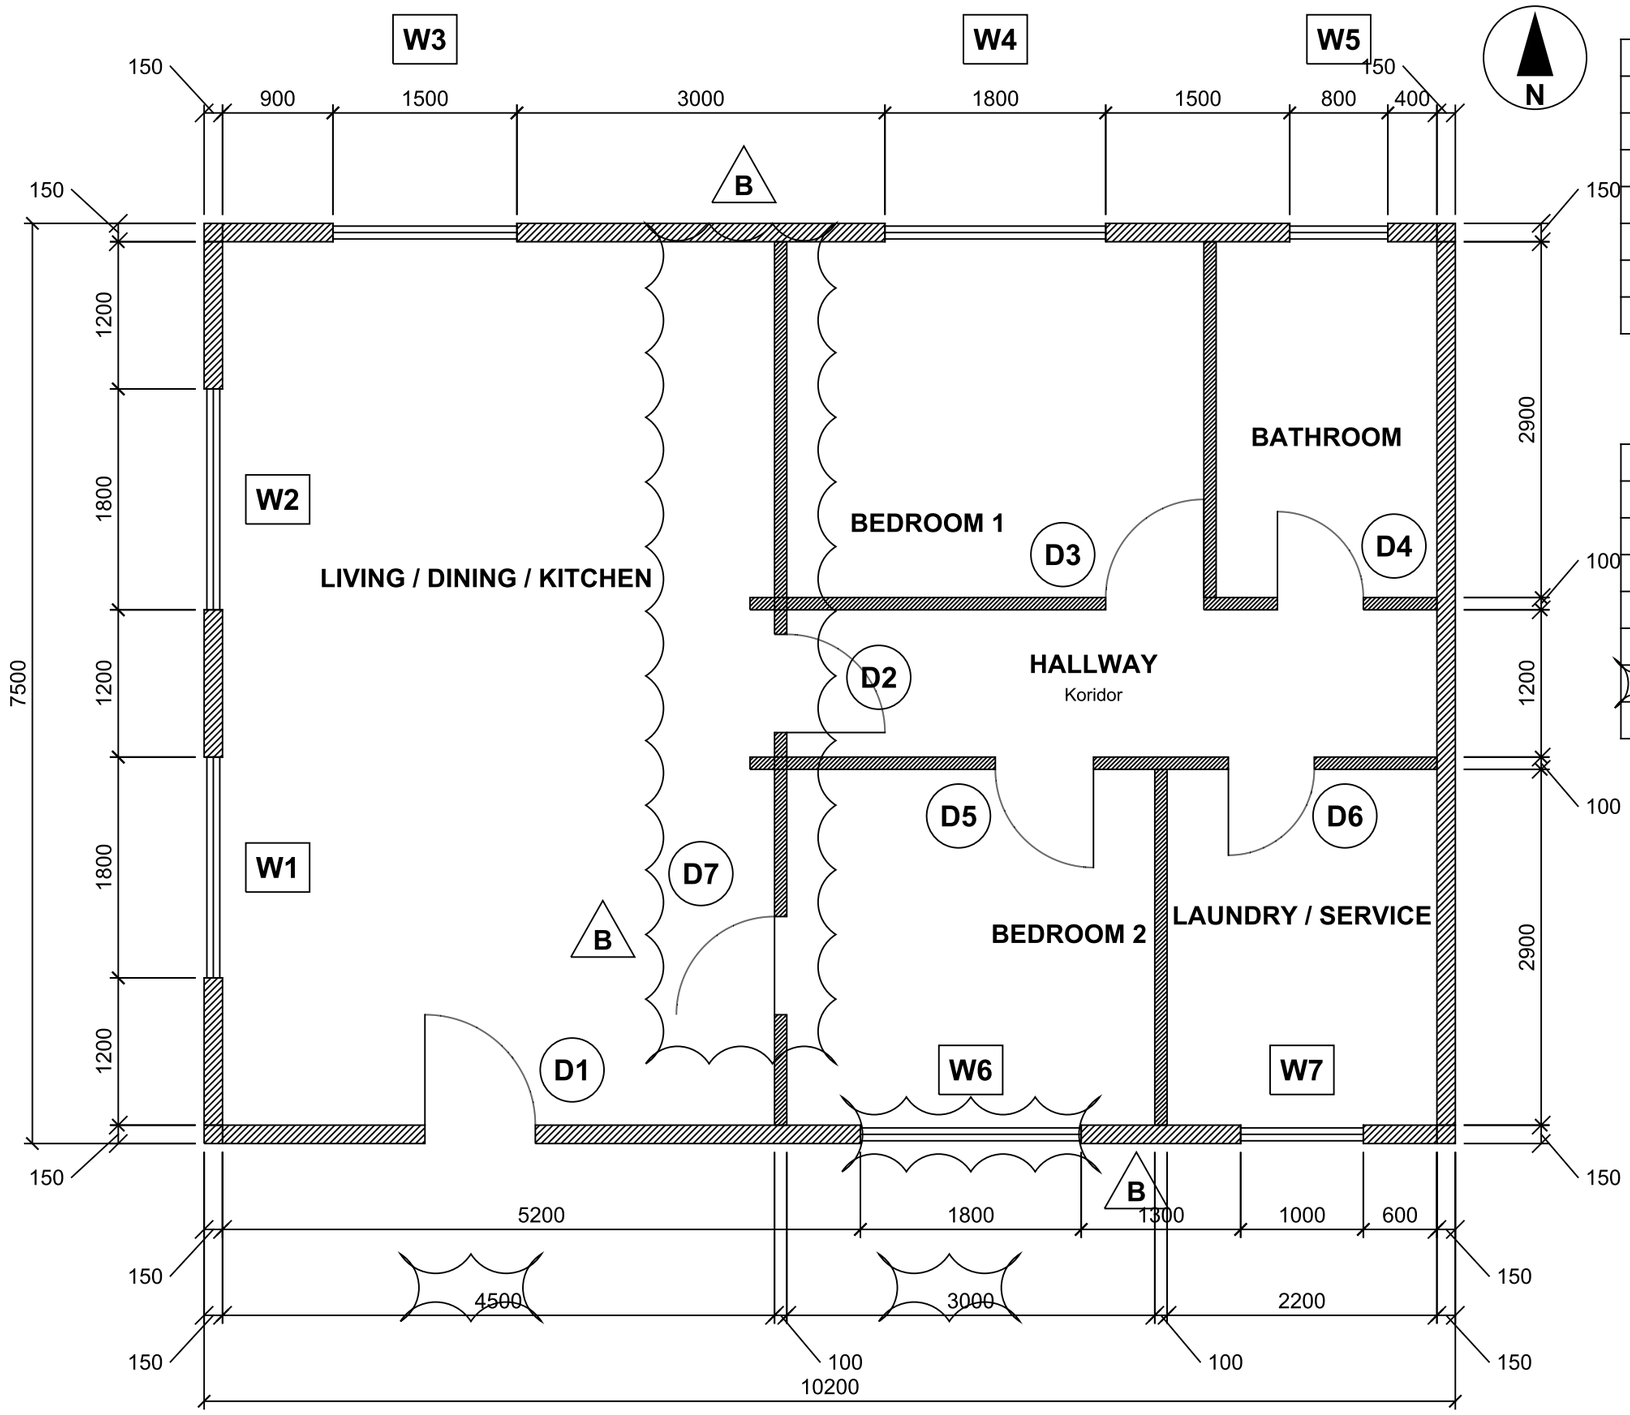

DOOR SCHEDULE

MARK	SIZE (mm)	TYPE	QTY	REMARKS
D1	900 x 2100	SINGLE SWING	1	ENTRANCE
D2	800 x 2100	SINGLE SWING	1	HALLWAY
D3	800 x 2100	SINGLE SWING	1	BEDROOM 1
D4	700 x 2100	SINGLE SWING	1	BATHROOM
D5	800 x 2100	SINGLE SWING	1	BEDROOM 2
D6	700 x 2100	SINGLE SWING	1	LAUNDRY
D7	800 x 2100	SINGLE SWING	1	BEDROOM 2 / LIVING

WINDOW SCHEDULE

MARK	SIZE (mm)	TYPE	QTY	REMARKS
W1	1800 x 1200	SLIDING	1	SILL +900
W2	1800 x 1200	SLIDING	1	SILL +900
W3	1500 x 1200	SLIDING	1	KITCHEN, SILL +900
W4	1800 x 1200	SLIDING	1	SILL +900
W5	800 x 600	AWNING	1	BATHROOM, SILL +1500
W6	1800 x 1200	SLIDING	1	SILL +900
W7	1000 x 600	AWNING	1	LAUNDRY, SILL +1500

WALL LEGEND / Legenda Dinding

150 mm EXTERNAL WALL

100 mm PARTITION

GENERAL NOTES / Catatan Umum

1. ALL DIMENSIONS IN MILLIMETRES.
2. DO NOT SCALE FROM THIS DRAWING.
3. DIMENSIONS TO STRUCTURAL FACES, U.N.O.
4. DOOR HEIGHTS 2100 mm, U.N.O.
5. VERIFY ALL DIMENSIONS ON SITE.

WEBKHAL
Technical drawing - 3D
webkhal.dev

PROJECT
RESIDENTIAL UNIT - TYPE 70
DEMONSTRATION PROJECT - NOT FOR CONSTRUCTION
Portfolio sample - fictitious project

SHEET TITLE
DIMENSION PLAN & SCHEDULES

SCALE	1:50 @ A3
UNITS	mm
DRAWN	J. Khalfallah
DATE	26.10.2026

SHEET
A-102

REV		
B	26.10.26	Site redlines incorporated
A	26.10.26	First issue